

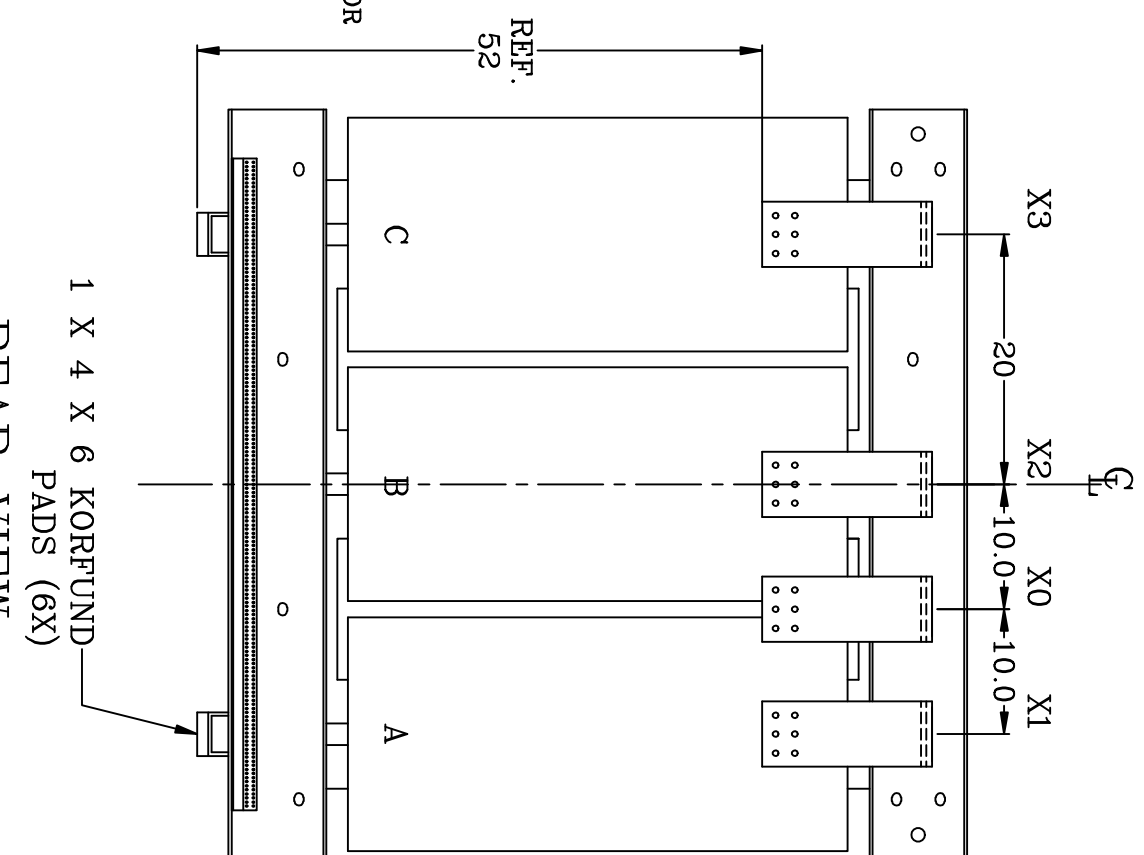
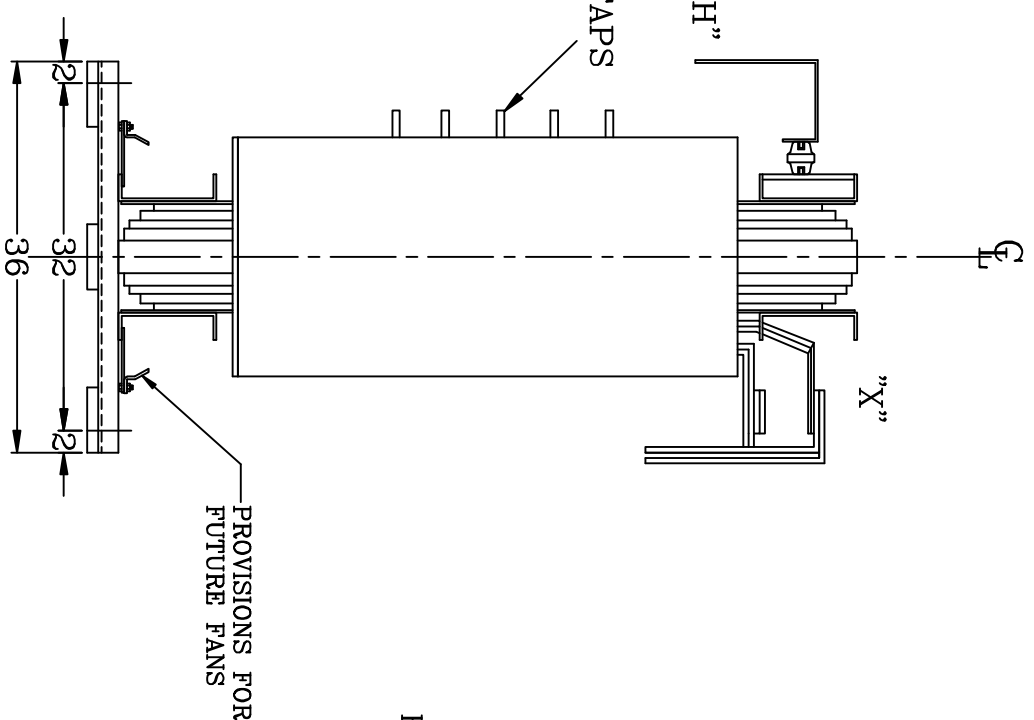


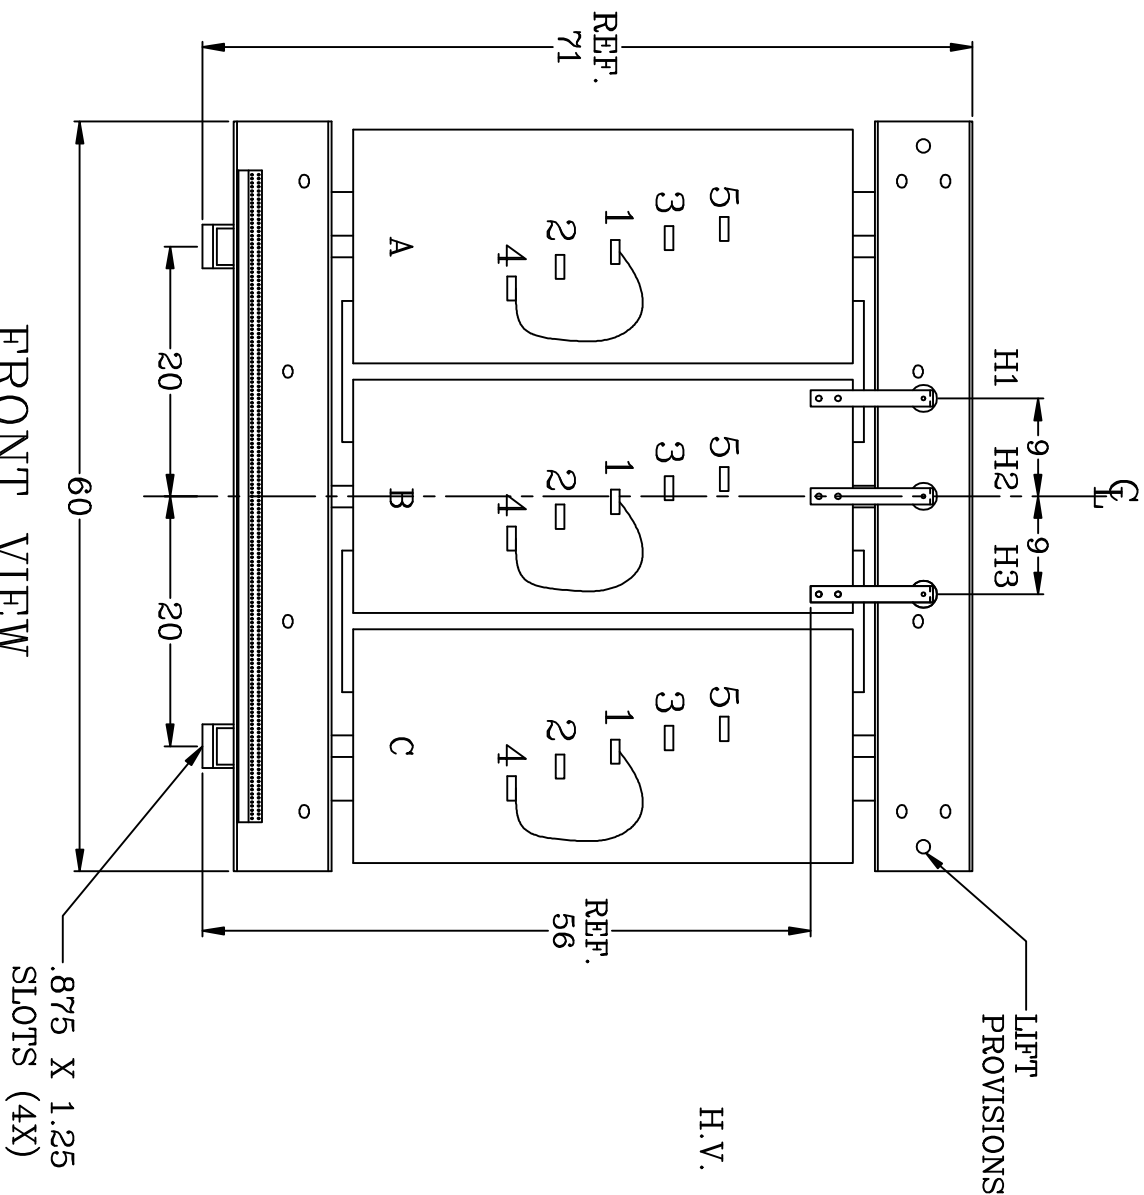

FRONT VIEW

RIGHT VIEW


REAR VIEW

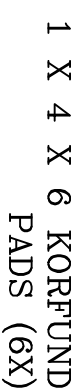

0  E										OLSON ELECTRICS CORPORATION RICHMOND, ILLINOIS										DRY TYPE TRANSFORMER CLASS AA/FFA			
KVA	1500	3	PHASE	HERTZ	60	%IZ	*	°C RISE	150														
H.V.	4160	Δ	30	KV BIL	208.2	WGT.	5800			LBS.													
L.V.	208Y/120	10	KV BIL	AMPS	4164	ND.	A69299																

SPECIFICATIONS

- 1) ALUMINUM WOUND
- 2) 220°C INSULATION
- 3) VACUUM PRESSURE IMPREGNATION
- 4) FUTURE FAN PROVISIONS
- 5) COMPLIANT TO 10 CFR PART 431 OF
DOE EFFICIENCY STANDARD
- 6) UL/CUL RECOGNIZED COMPONENT,
UL FILE E143467
- 7) (2) NAMEPLATES ARE PROVIDED
- 8) ALL TERMINATIONS TO BE BELOW
CORE CLAMPS

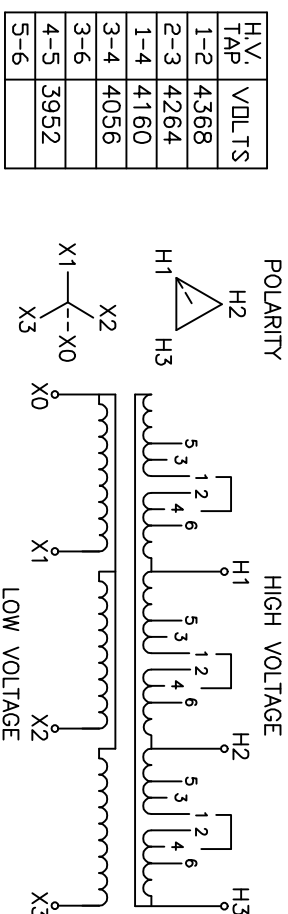

COMPLIANT TO DOE 10 CFR PART 431

DE-ENERGIZE TRANSFORMER BEFORE CHANGING TAPSS

AS BUILT DRAWING	
"H" TERMINAL DETAIL .25 x 1.5 ALUMINUM	"X" TERMINAL DETAIL (2) .5 X 6 ALUMINUM
0.50	

REV.	01	CHECKED BY	TV	DATE	3/16/12
OLSUN ELECTRICS CORPORATION RICHMOND, ILLINOIS					
REVISIONS: 01		APPROVED BY:			
DIMENSIONS IN INCHES		DRAWN BY: TSH			
DRAWING TITLE: DRY TYPE TRANSFORMER SPECIFICATIONS AND DIMENSIONAL DATA		DATE: 3/12/12			
		DRAWING NUMBER: A69299			